


EXISTING LAYOUT - 1:100

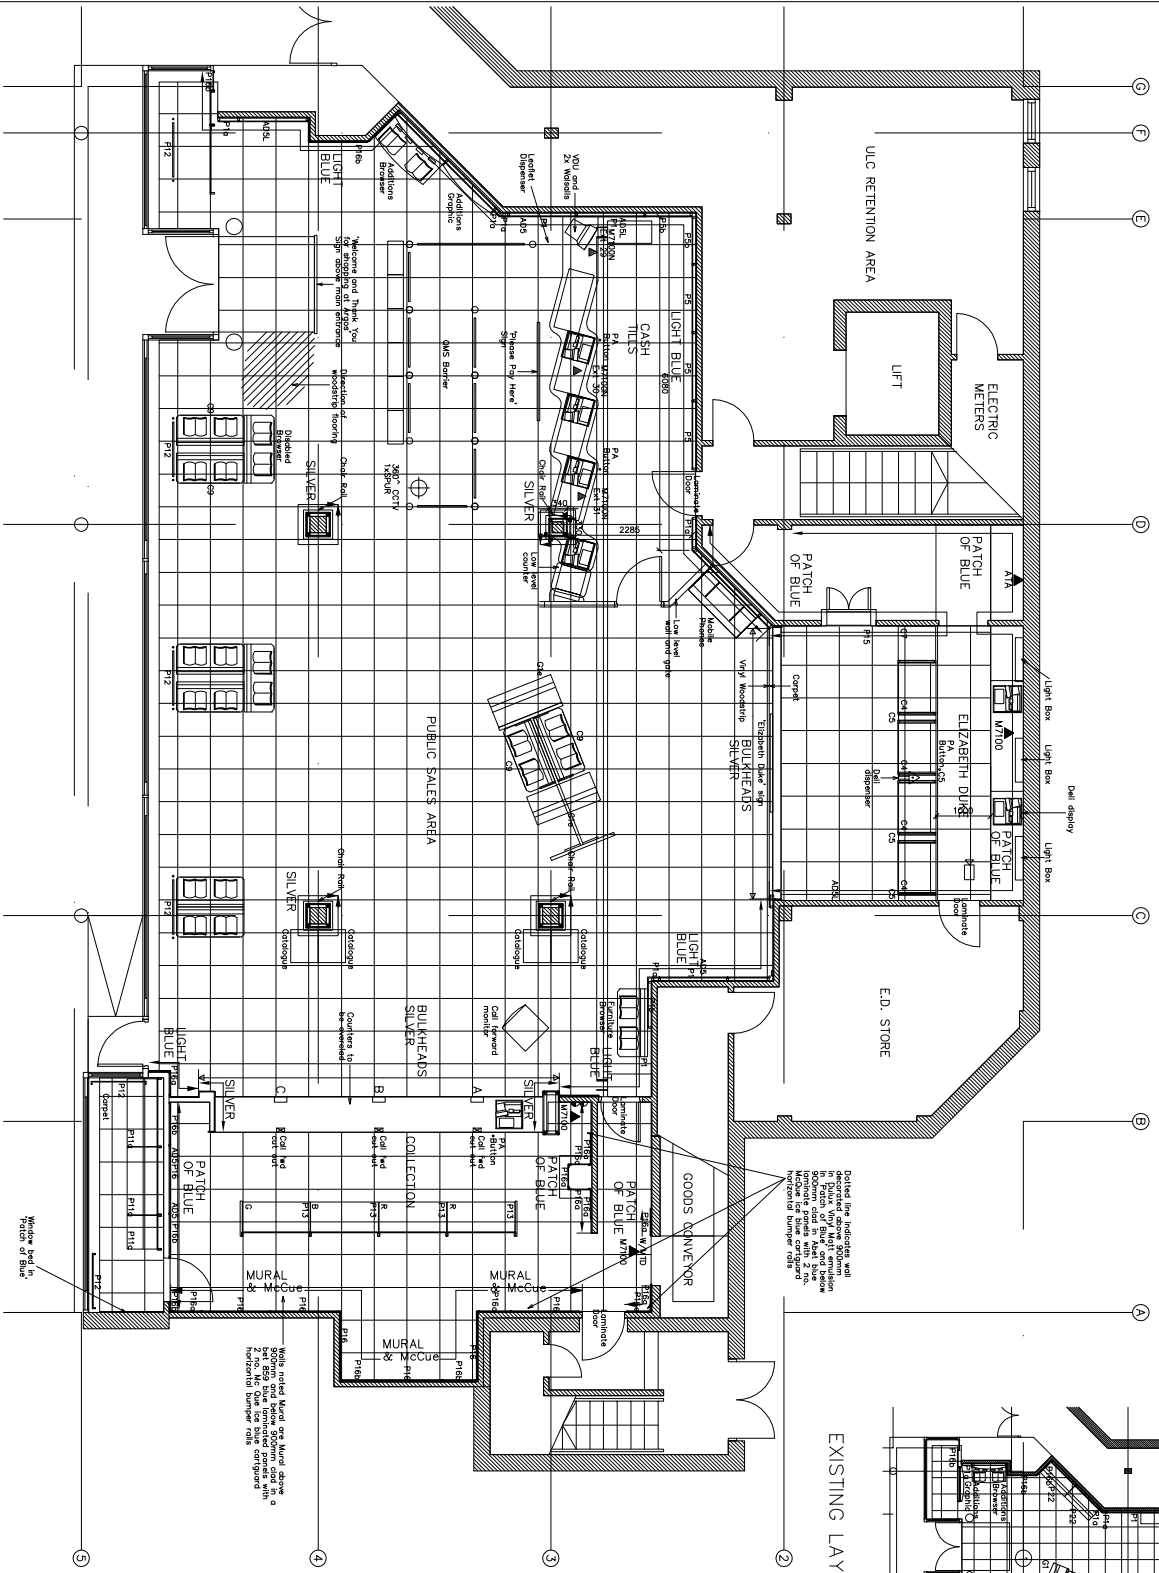

PROPOSED LAYOUT - 1:50

Partial floor headroom not detailed above 2000mm in Public Area and below 2000mm in other areas. Minimum headroom in Public Area is 2.0m. ULC Area has been designed to be 2.0m high.

Walls noted Mural are Mural above 2000mm and below 2000mm. ULC Area has been designed to be 2.0m high.

FORECAST	DATE
FORECAST	16/05/2002
ACTUAL	20

AS BUILT	DATE
AS BUILT	16/05/2002
REVISION	E

AS BUILT

PROJECT: ARGOS
CLIENT: ARGOS
DRAWN BY: AVR
DATE: 16/05/2002
CHECKED BY:

SCALE: AS SHOWN

DRAWING TITLE: AS BUILT LAYOUTS BRIGHTER SHOPPING

DRAWING NO: 039426/01

REVISION: E

DEAN & BOWEN
100, 101, 102, 999, 1000