


Notes:

This drawing is the copyright and property of The Royal Bank of Scotland plc. It must not be copied or published without written consent.

Do not scale from this drawing.

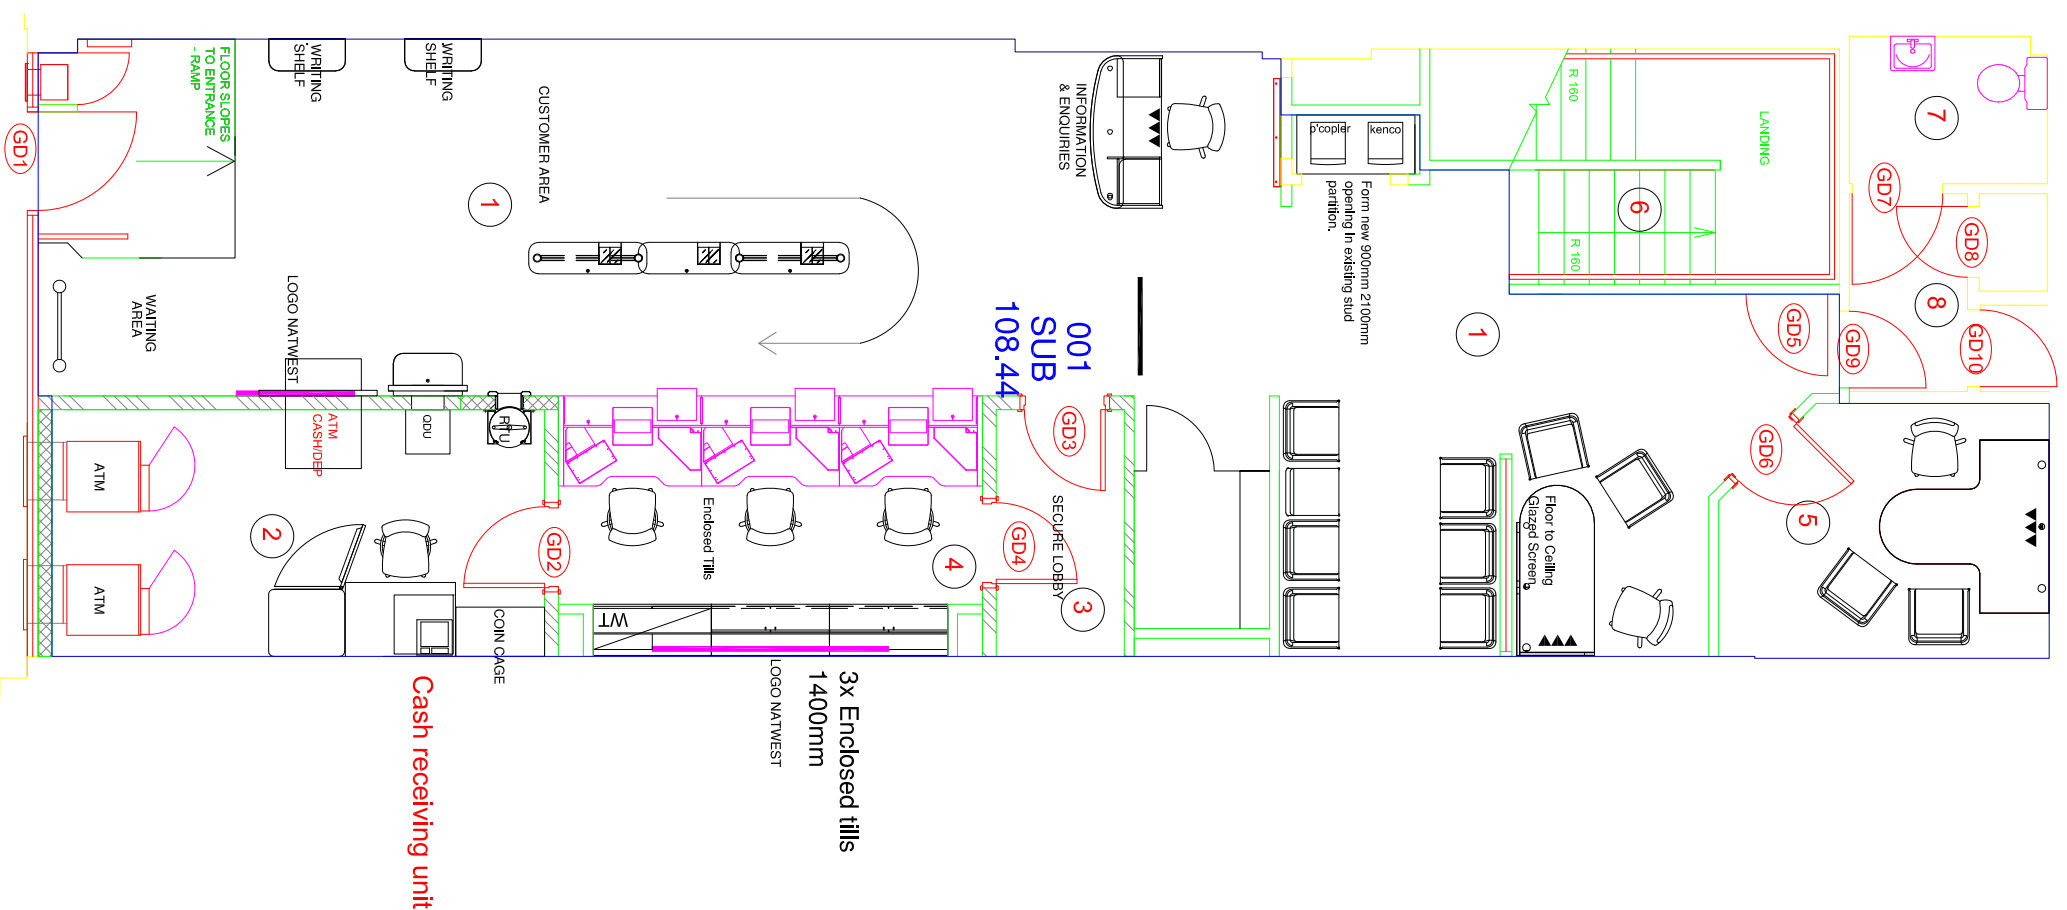

rev	description	date
M	THC update (sublet) as per pt	06/09/17
L	THC	Nov 08
K	As Built	Sep07
J	Kenco Repositioned due to stud partition being load bearing. Information point modified.	June07
H	Secure Lobby Moved	May07
G	DDA Note Removed	May07
F	Enclosed tills added	Apr07
E	Cash receiving unit added	Apr07
D	DDA Tilt Added	Mar07
C	First Issue	Mar07



project
 Royal Bank Of Scotland Group
 Birmingham
 134 New Street

title
 Proposed GA Plan
 Ground Floor Plan

scale
 1:100

dn	chk	app
JC	AW	

date	date	date
04/04/07		


consultants' drawing number	brand
PCPT-3354-00-GA-RL-01	
the drawing number	rev.
PCPT-TMP059-00-GA-RL-01	M

Group Property

Notes:

This drawing is the copyright and property of The Royal Bank of Scotland plc. It must not be copied or published without written consent.

Do not scale from this drawing.

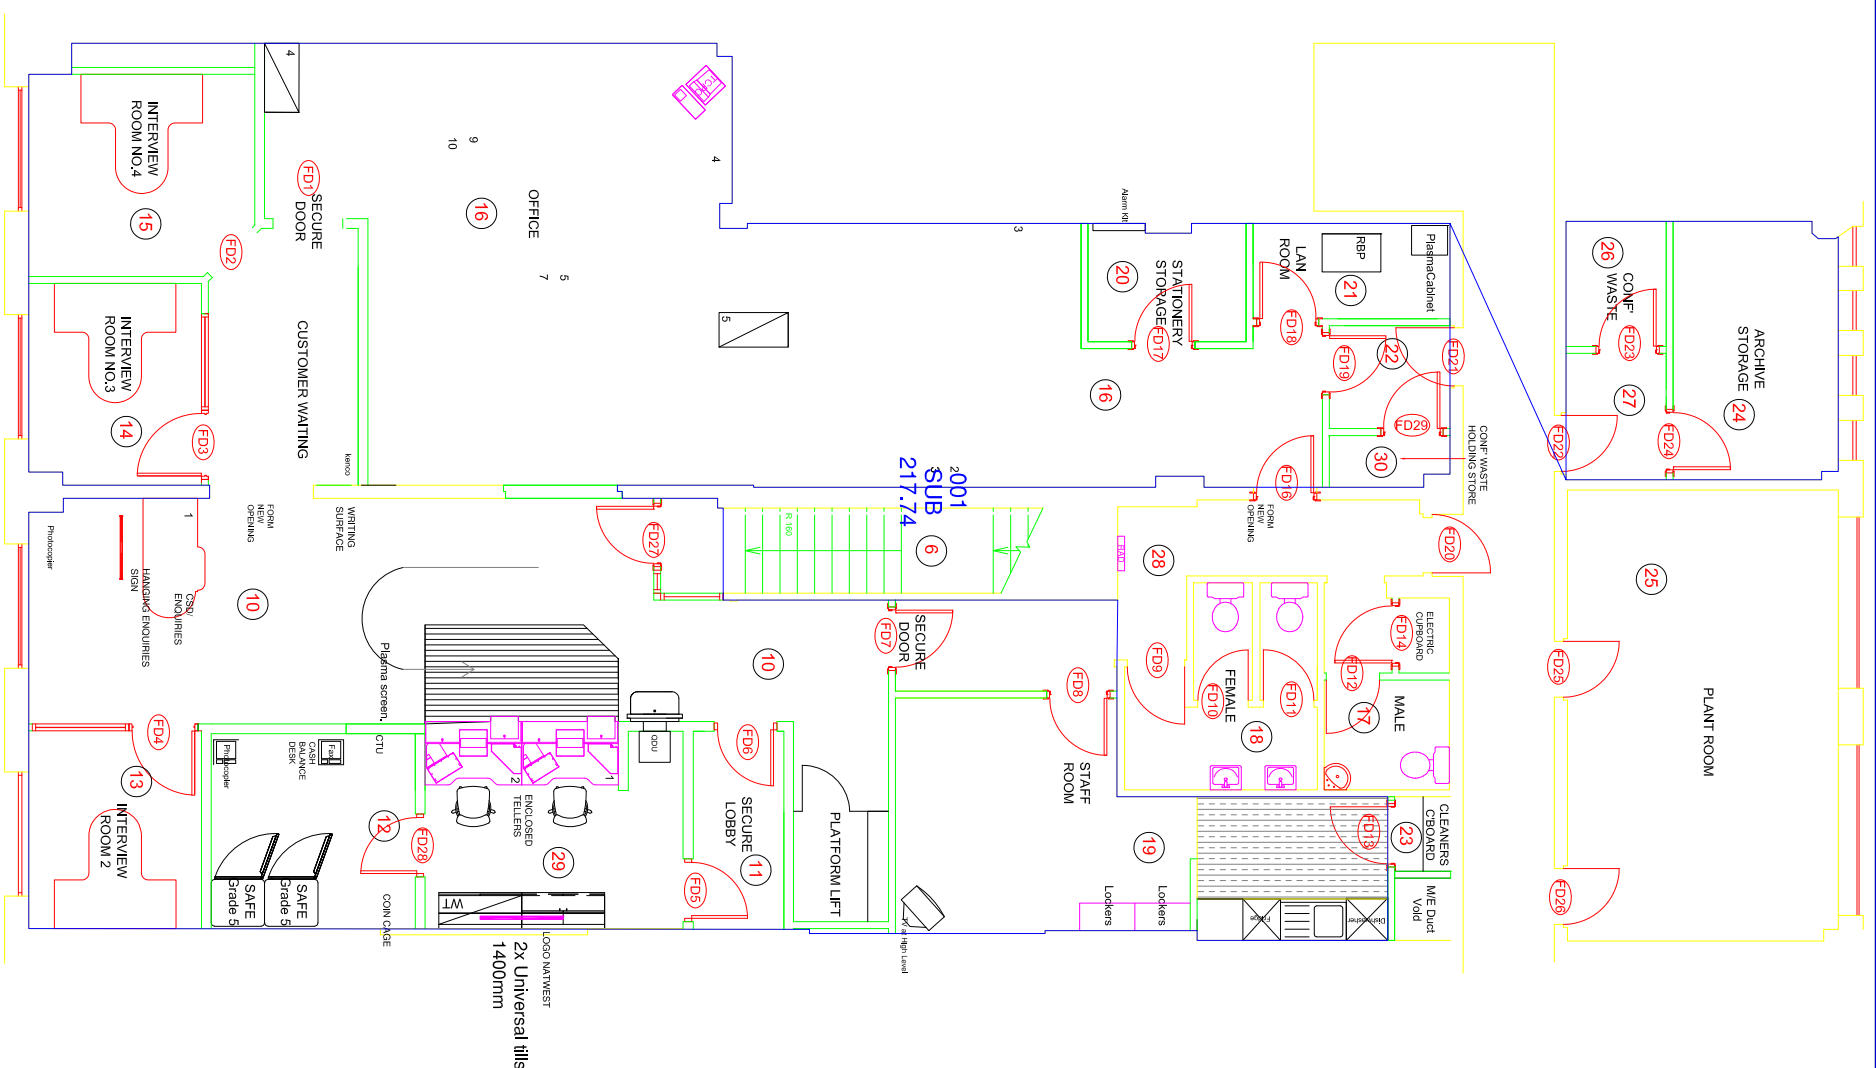

FIRST FLOOR PLAN

rev	description	date
M	THC update (subtle) as per pdf	06/09/17
L	THC	Nov 08
K	As Built	Sept 07
J	Photocopier Added	July 07
H	Plasma Box Moved to Stationery	July 07
G	Kerico Coffee Machine Added	May 07
F	Easy chair to staff room changed	Apr 07
E	Cont' holding store & cash receiving unit added	Apr 07
D	Lockers Increase In Size	Mar 07
C	M/E Duct Cupboard Added	Mar 07
	First Issue	Mar 07



project
Birmingham
134 New Street

title
Proposed GA Plan
First Floor Plan

scale
1:100

dm	chk	app
JC	AW	

date	date	date
17/07/07		

consultants' drawing number	brand
PCPT-3354-01-GA-RL-01	
the drawing number	rev.
PCPT-TMP059-01-GA-RL-01	M