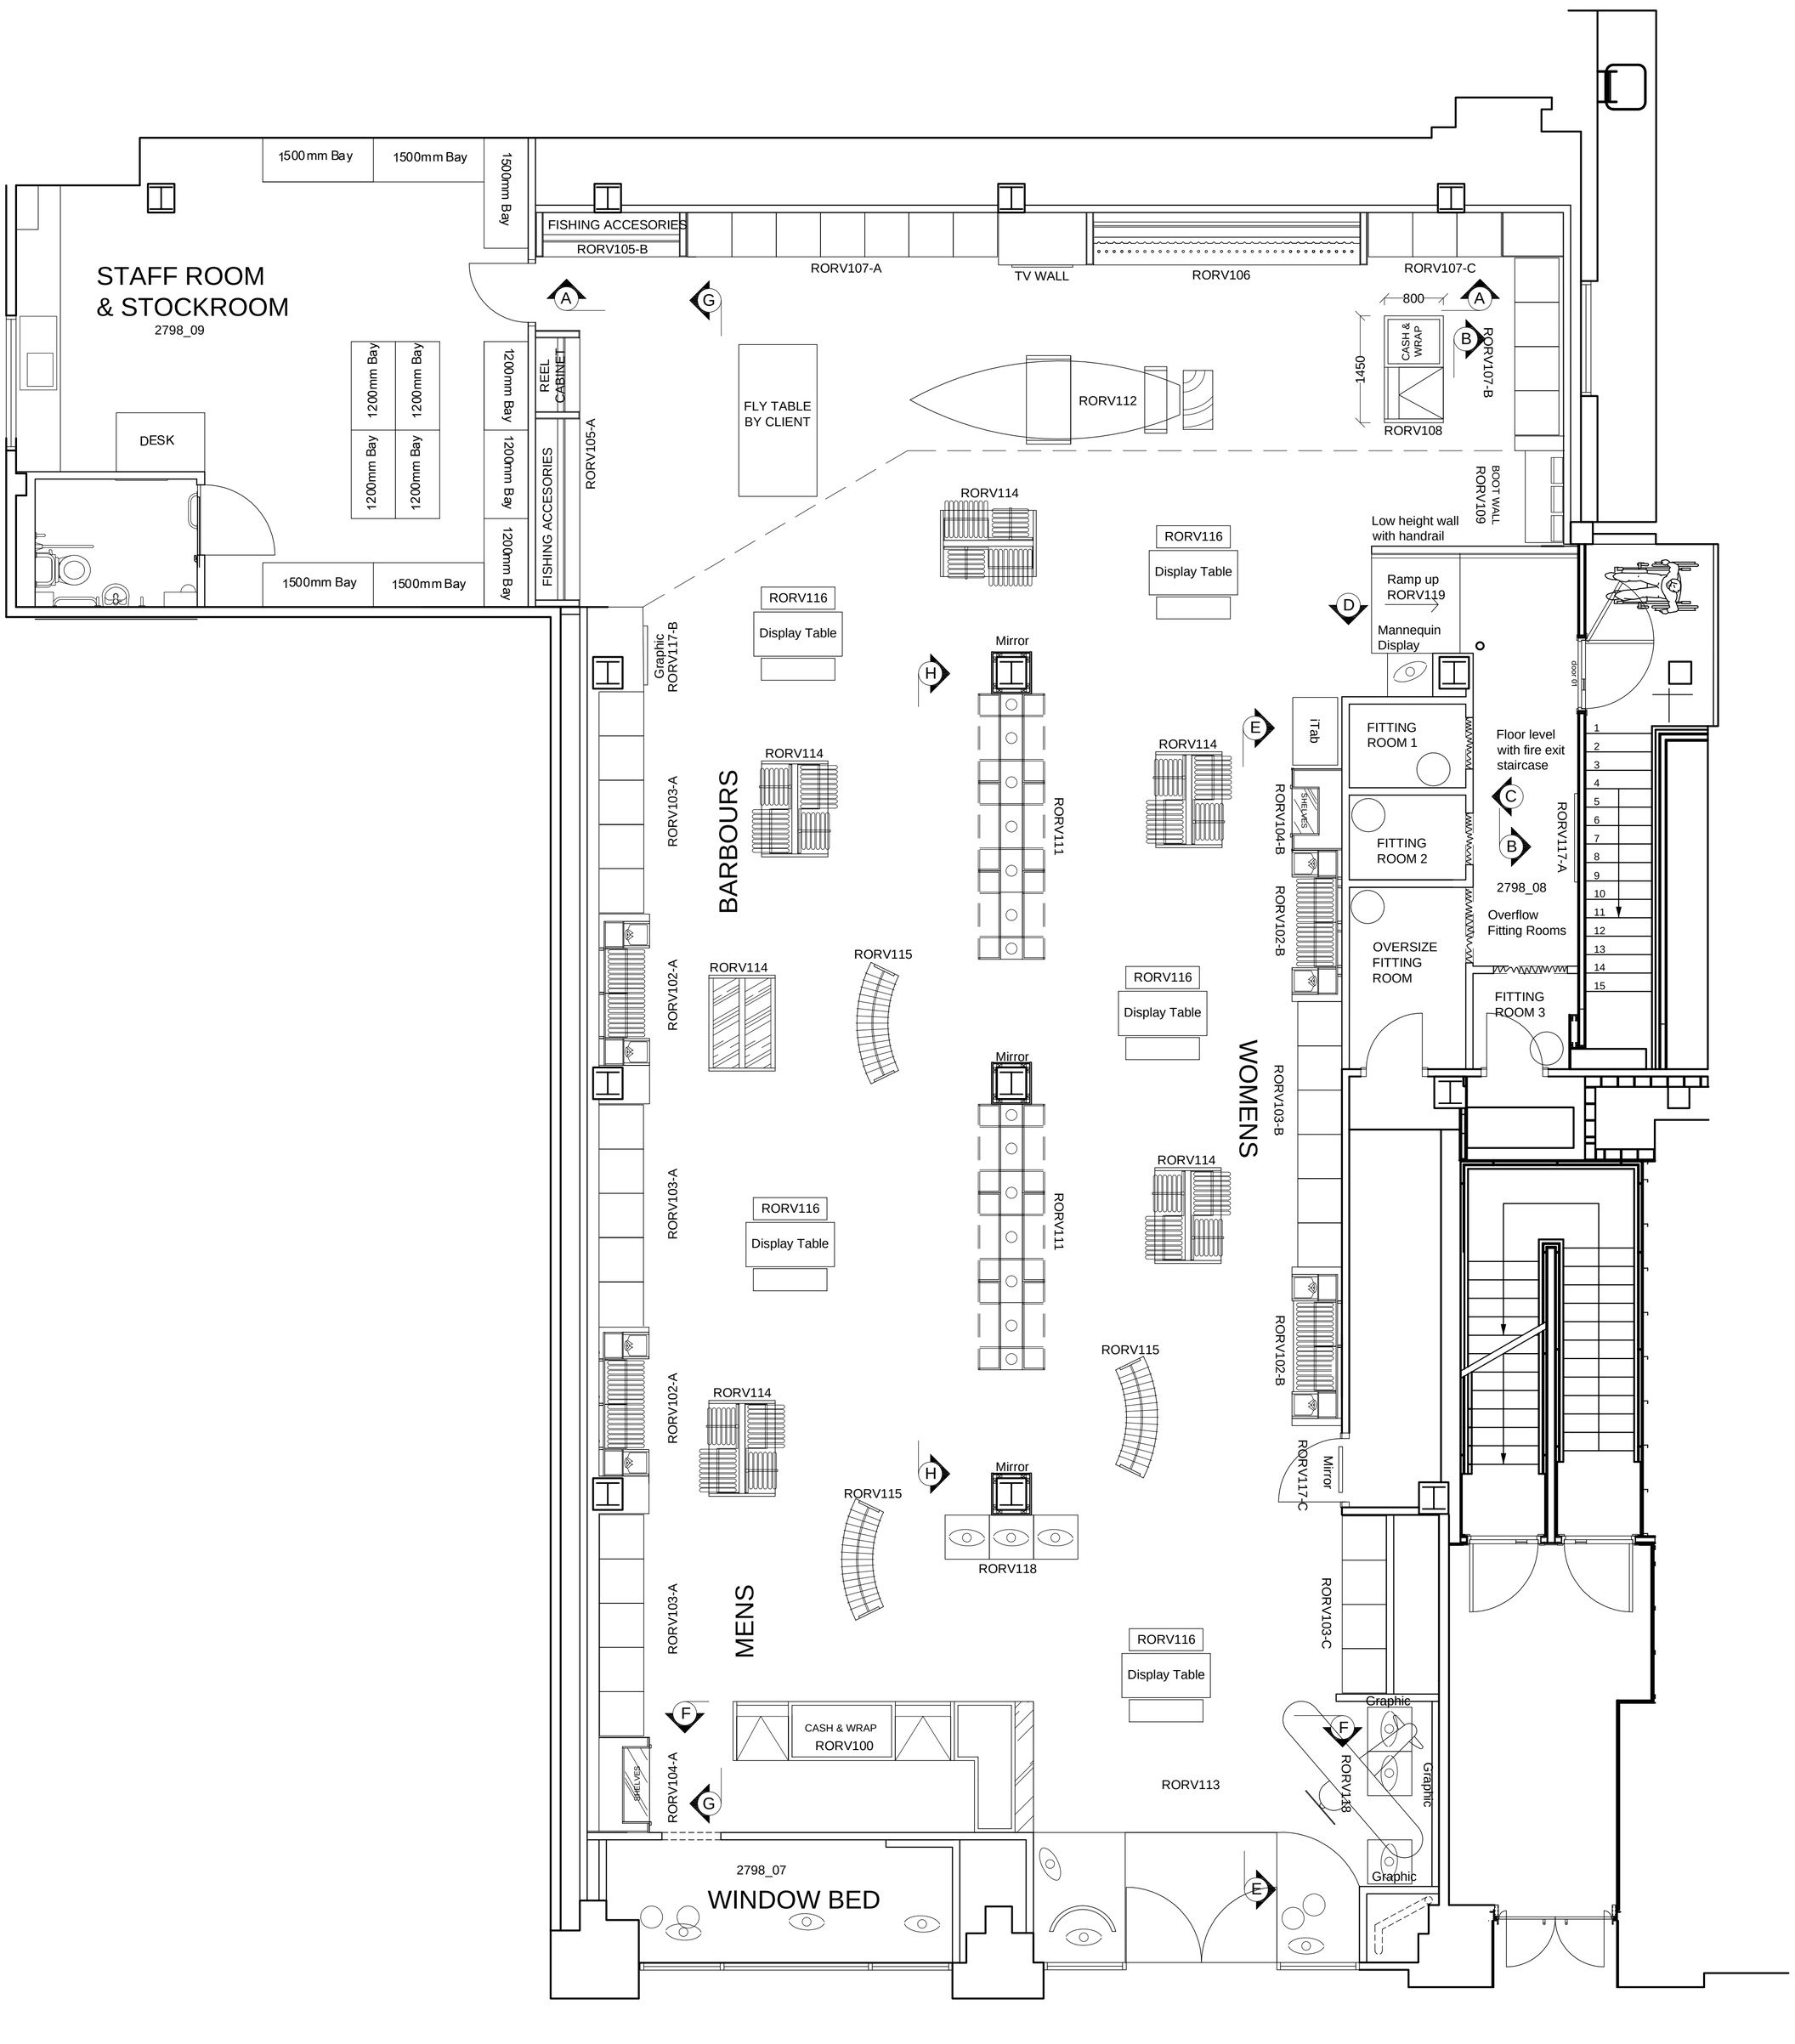

The contractor is to check all dimensions on site and report any error or omissions to Jamieson Smith Associates.
This drawing is not to be scaled.

Revision	Amendments	Date	By
A	Updated from Client meeting	03/07/13	RB
B	Disabled refuse point added in by landlord	18/07/13	RB
C	Fitting room added back in	23/07/13	RB
D	Plan updated	02/08/13	RB
E	Ramps added in	13/08/13	RB
F	Ramp added to rear fire exist	13/08/13	RB
G	Site survey undertaken Drawing updated	23/08/13	RB
H	Ramp changed	28/08/13	RB
I	Ramp removed	03/08/13	RB
J	Smoke lobby removed	03/08/13	RB
K	iTab added	19/09/13	RB
L	Stockracking updated	18/11/13	RB

Disclaimer: Any discrepancies on or between all drawings issued must be drawn to the attention of the Designer for clarification.
The contractor is to check all dimensions on site and report any error or omissions to Jamieson Smith Associates.
This drawing is not to be scaled, use only written or calculated dimensions.
This drawing is design intent only and is not for use in manufacturing or construction.

Jamieson Smith Associates
Retail and Commercial Design
Interior Contracting Services
13 Devon Square, Newton Abbot, Devon TQ12 2HN
Tel: (01626) 336083 Fax: (01626) 336103
enquiries@jamieson-smith.co.uk

Client: Orvis

Project: 11b Regent St
London
SW1

Description: Proposed Plan
AS BUILT

Scale: 1:50 @ drawing size: A1

Drawing by: RB Date: 20/06/13

Drawing No.: 2798_01 Rev.: L

Copyright
This Drawing and information displayed is the confidential property of Jamieson Smith Associates and shall not be copied or used for any purpose without the written permission of an agent of the company.